

CITY OF SPRINGFIELD  
MEMO TO FILE


On Wednesday, July 10, 1991, I went back to 2218 E. Lark and 2219 E. Swallow. There was some question about a possible discharge coming from the house at 2219 E. Swallow so I went to that address first. No one was home. I looked around in the back yard and walked all around the foundation of the house. I also looked in the bushes around the foundation, but didn't see any kind of discharge pipe or any evidence that laundry waste had ever been discharged to the yard. I then went to 2218 E. Lark and talked to Mrs. Reneer, the renter of the house. She told me that the septic tank is in the front yard, but when she uses the washing machine water comes out in the back yard. We walked around to the back of the house. The ground was wet next to the chain link fence on the west side of the yard about 1/3 to 1/2 of the way up the lot. The Renners had put up chicken wire over the wet spot to keep their dogs out of the water. She said she had never seen a pipe there. I dug around a little under the chicken wire, but couldn't find a pipe. Mrs. Renner told me the owner of the house was Pat Robbins, who lived in Nixa. I walked around to the front yard and there was a wet spot on the west side of the lawn near a tree.

*Karen Chandler*

Karen Chandler  
Water Pollution Control Inspector  
Surveillance and Enforcement

KC/jb

↑  
N

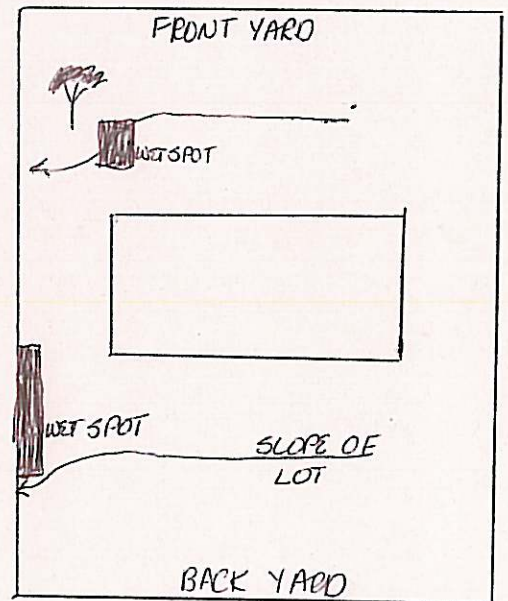

2218 E. LARK

JUL 19 1991

CITY OF SPRINGFIELD  
CITIZENS REQUEST

MAY 24 1991

Assigned to Santa Rosa SERV

Control No. \_\_\_\_\_ Received \_\_\_\_\_ AM \_\_\_\_\_ PM Date 5-24-91 By LCS

Reported by Robert M. Bunn 2218 E. Lark 725-3096  
Name Address Phone

Request progress reports ☒ Yes ☐ No How & when to contact \_\_\_\_\_

Location of problem 2219 E. Swallow Owner \_\_\_\_\_  
Address \_\_\_\_\_  
Occupant \_\_\_\_\_

Condition reported: Not connected to sewer in violation  
of Chapter 31 Article III, Section 31-22  
of the Springfield City Code.

Investigated 1:30 <sup>AM</sup> ~~PM~~ 5/24/91 By K. CHANDLER

Conditions found: I WENT TO 2219 E SWALLOW AND WALKED ALL AROUND  
BACK YARD. THERE WAS NO EVIDENCE OF A SURFACING SEPTIC TANK AT THIS  
ADDRESS. I called 725-3096; Mr. McGinnis mother. This  
she had problem at 2218 <sup>E. LARK</sup> and taking out permit on 5-28-91 to  
connect. She knows of no problem at 2219 E. Swallow. Randy McGinnis

Action taken: Will attach copy of permit to complaint form and  
send copy to Health Dept. for info.

Abatement order issued via \_\_\_\_\_ Date \_\_\_\_\_ To be abated by \_\_\_\_\_

Progress report made to Health Via copy of permit Time \_\_\_\_\_  
Date \_\_\_\_\_

Investigation for compliance \_\_\_\_\_ <sup>AM</sup> ~~PM~~ 7/11/91 By Karen Chandler

Conditions found: Failing septic tank system (leach field for  
washing machine)  
Corrected 7/11/91 by connection to City Sewer.

Summons issued to \_\_\_\_\_ Court date \_\_\_\_\_

Additional action required: \_\_\_\_\_

Progress report made to \_\_\_\_\_ Time \_\_\_\_\_  
Date \_\_\_\_\_

Reviewed by \_\_\_\_\_ Remarks \_\_\_\_\_

2218 E. LARK



CITY OF SPRINGFIELD, MISSOURI  
SEWER CONNECTION PERMIT  
-----

Address: 2218 E LARK Date: 06/19/91  
Lot#: 19 Subdivision: HILLTOP HEIGHTS  
Applicant Name: POINDEXTER MECHANICAL  
Inside City: X Outside City: Water Meter Size: 5/8"  
Type of Permit: [Regular] R Connection Fee Paid [y/n]: N \$0.00  
Outside Sewer District Fee Paid [y/n]: N \$0.00  
Conditional Permit (Dead End Sewers): CU Water [y/n]: Y

## \*\*Wye Location:

118' EAST OF WEST MANHOLE OR 214' WEST OF EAST MANHOLE, 25' LATERAL, 3.3'  
DEEP, 8" PVC, FEE WAIVED, PAYING MONTHLY SEWER BILL

NOTE: All sewers must be inspected by City or County prior to backfilling.  
It is the Owner's and Plumber's responsibility to comply with the City's  
and County's call-in requirements for inspections.



Approved: Superintendent of Sanitary Services

-----  
AUTHORIZATION TO TAP SANITARY SEWER  
\*\*\* (TAPPING TO BE DONE BY LICENSED PLUMBER ONLY)

Description of Line To Be Tapped:  
Approximate Location Of Tap:

Approved: Superintendent of Sanitary Services


-----  
White-Inspection Report (to be returned to Sanitary Services after inspection); Gold-City or County File; Lt. Yellow-Sanitary Services File;  
Pink-Plumber  
-----

## INSPECTION REPORT

Sewer connect inspection made by me on 7-11-91 (date).  
Connection at Designated Wye: ☒ Yes ☐ No. If "No", show tap location below.

Tapped at the Following Location & Manner: \_\_\_\_\_  
(Measured from Center of Nearest Manhole)

-----  
If "Conditional Permit" [Dead-End Sewers] Sewer Line capped at the following location: \_\_\_\_\_

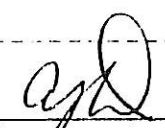  
\_\_\_\_\_  
(Inspector)